




THIRD FLOOR

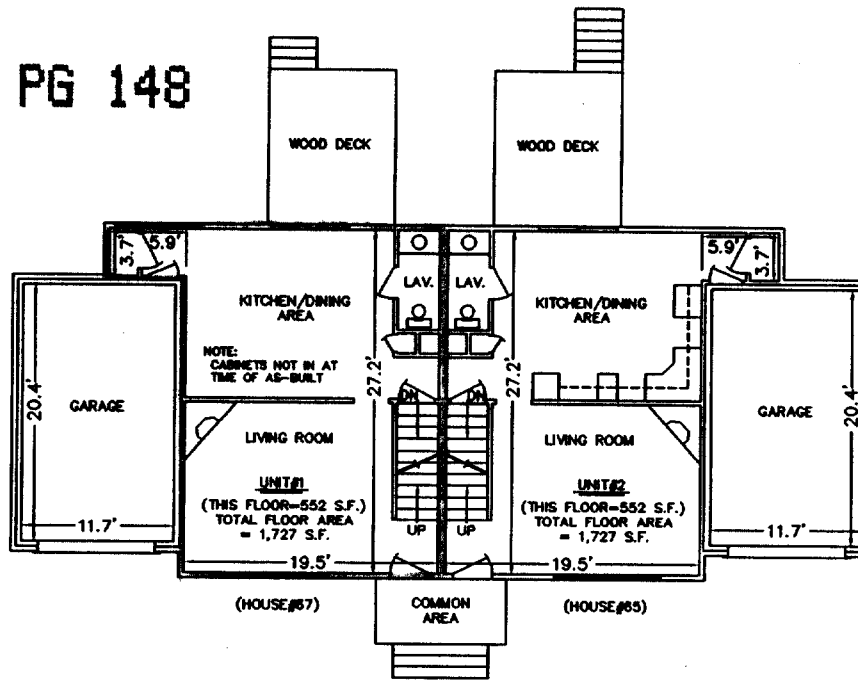

FIRST FLOOR

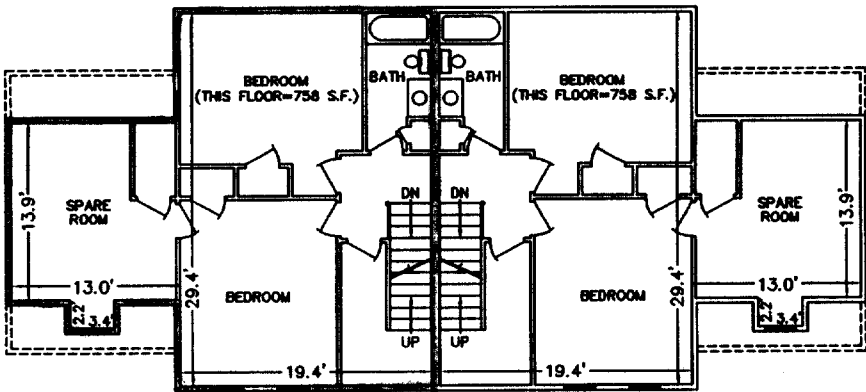

SECOND FLOOR

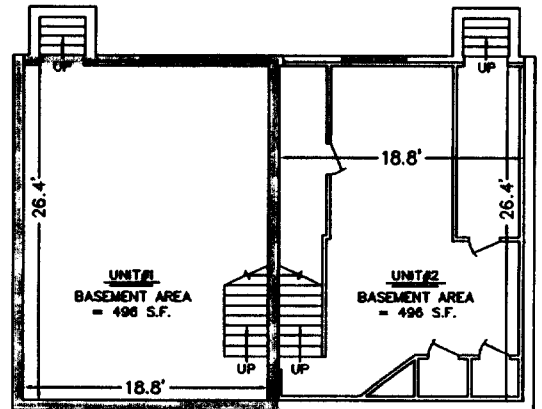

BASEMENT FLOOR

65-67 PRESCOTT STREET CONDOMINIUM
 NORTH ANDOVER, MASS.
 PORTION OF FLOOR PLANS-SCALE: 1"=15'



I HEREBY CERTIFY THAT THIS PORTION OF THE FLOOR PLANS FOR THE 65-67 PRESCOTT STREET CONDOMINIUM OF LAWRENCE, MASS. SHOWS THE UNIT DESIGNATION OF UNIT#1 BEING CONVEYED AND THE IMMEDIATELY ADJOINING UNIT, ITS LOCATION, DIMENSIONS, APPROXIMATE AREA, MAIN ENTRANCE AND IMMEDIATE COMMON AREAS TO WHICH IT HAS ACCESS, AS BUILT.

William S. MacLeod

WILLIAM S. MacLEOD
 REG. PROF. ENGINEER

8-14-01

DATE

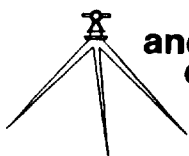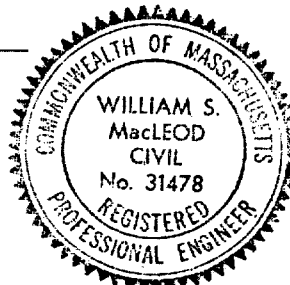

**andover
 consultants
 inc.**

1 East River Place
 Methuen, Massachusetts 01844